

**DART**


DESIGN <i>KE</i>	DRAWN BY <i>KE</i>	DART AEROSPACE LTD VICTORIA INTERNATIONAL AIRPORT, CANADA	
CHECKED <i>DKW</i>	APPROVED <i>DK</i>	DRAWING NO. D2527	REV. B SHEET 1 OF 2
DATE 97.10.03		TITLE PROP ASSEMBLY	SCALE NTS
A	96.12.13	NEW ISSUE	
B	97.10.03	CORRECT TYPOS, REMOVED CLIP	
B1	<del>CP</del> 01.05.09	CHANGE TO D3015-3	
B2	<del>CP</del> 02.03.22	ADD FINISH	

**RELEASED**  
471023 KE  
TSR 4424**UNDER REVIEW**  
CP 01.03.27


Qty	Part Number	Description
2	D2022-101	SPACER
1	D2012-107	CLEVIS
1	D2527-1	PROP
1	D2630	MOUNTING BRACKET
1	D2705	SUPPORT BRACKET
1	AN4-4A	BOLT
1	AN4-10A	BOLT
3	AN960JD416	WASHER
1	AN960JD516	WASHER
2	MS21042L4	NUT
1	SL69-BS	BALL STUD
1	5/16-18 UNC	LOCKNUT (D3015-3)

**DART**OF COPY ISSUED  
03/03/96

DESIGN	DRAWN BY	DART AEROSPACE LTD VICTORIA INTERNATIONAL AIRPORT, CANADA
CHECKED	APPROVED	DRAWING NO. D2527
DATE	97.10.03	REV. B SHEET 2 OF 2 TITLE PROP ASSEMBLY SCALE NTS

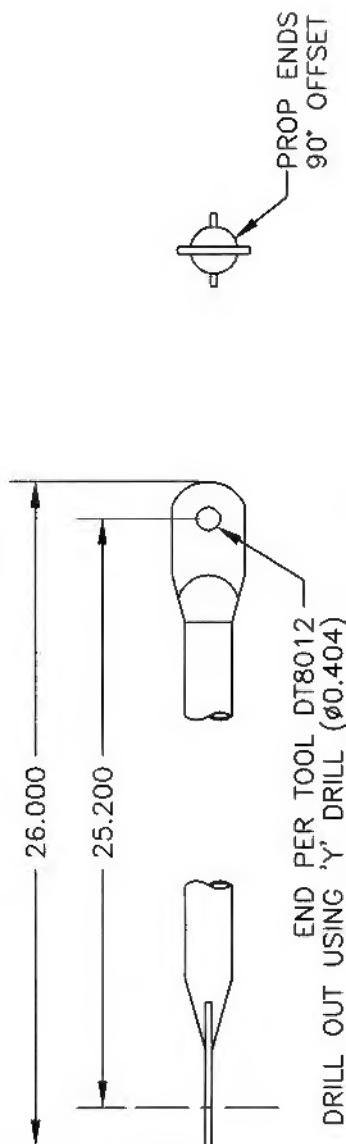**RELEASED**  
971023 KE  
TSR A424**UNDER REVIEW**  
C 01.03.27

MATERIAL: 316/318 SS ANNEALED 0.50 OD 0.035 WALL  
FINISH: POWDER COAT WHITE (4.3.5.2) PER DART QSI 605 4.3 82  
D2527-1

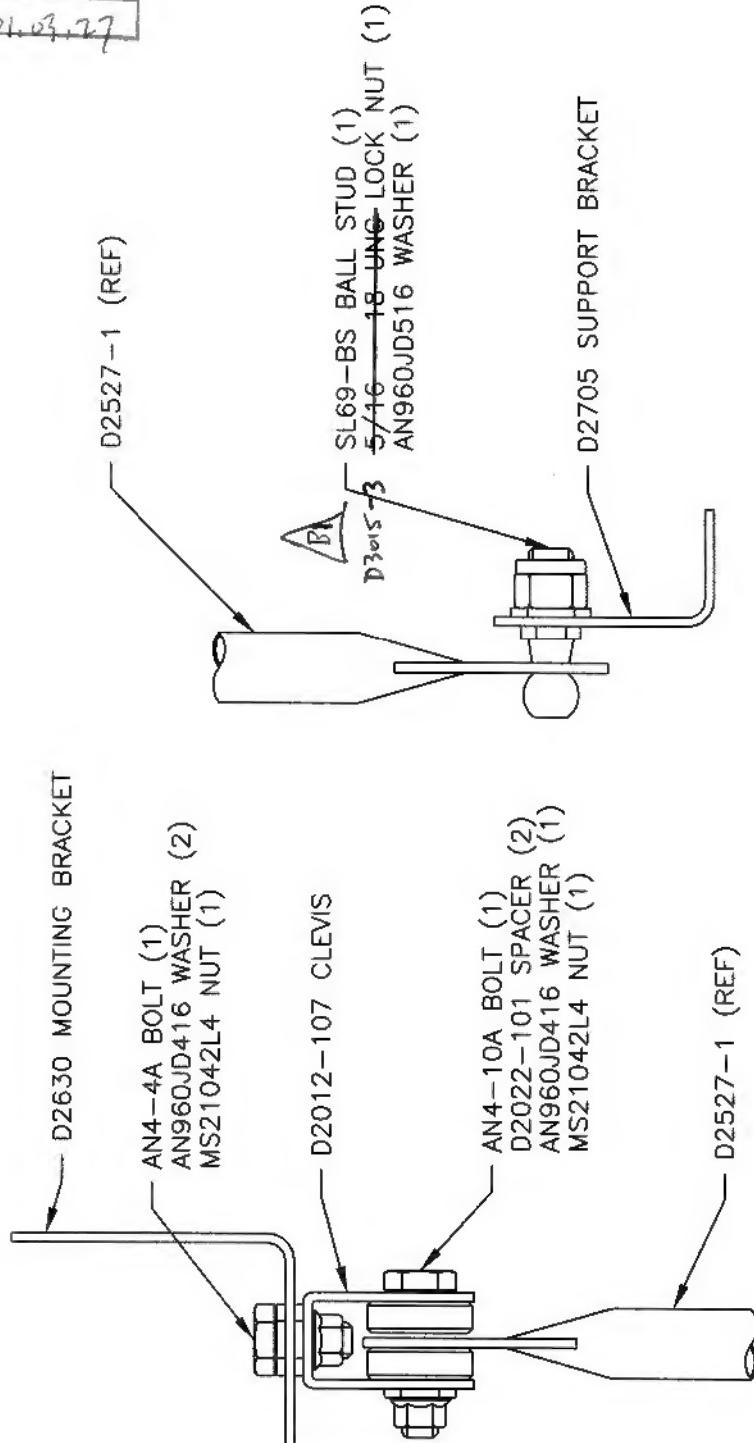

D2527-041 PROP ASSEMBLY